

LEGEND:	
	WATER MAIN
	ELECTRIC POWER CABLE
	BT LINE / DUCTS
	FOUL DRAINAGE LINE
	STORMWATER LINE

- FOUL INSPECTION / SAMPLE CHAMBER
- BT CONNECTION / JUNCTION BOX
- KLARGESTER BIODISC TREATMENT PLANT
- KLARGESTER FIREWATER STORAGE TANK

- BT DUCT CONNECTION POINT
- ELECTRICITY "POT END" FOR PLOT
- SCOTTISH WATER BOUNDARY BOX FOR PLOT
- STORMWATER CONNECTION CHAMBER

SITE SERVICE LAYOUT PLAN  
SCALE 1:250

SITE SERVICE LOCATION PLAN  
SCALE 1:1000

Notes:

FOUL:  
FOR CONSTRUCTION DETAILS OF CHAMBERS, TRAPS AND SOAKAWAYS, PLEASE REFER TO HGA DRAWING NO. 3415.105 REV C

WATER MAIN:  
FOR CONSTRUCTION / LAYOUT DETAILS OF VALVE ARRANGEMENTS, HYDRANTS, ETC, PLEASE REFER TO HGA DRAWING NO. 3415.110 REV B

ELECTRICITY:  
SSE SUPPLIED POT-ENDED TAILS ARE LOCATED INSIDE EACH PLOT IN LOCATION AS INDICATED

WATER:  
PAT MUNRO / SW SUPPLIED BOUNDARY BOX TAILS ARE LOCATED INSIDE EACH PLOT IN LOCATION AS INDICATED

BT:  
BT SUPPLIED ROPED DUCT TAILS ARE LOCATED INSIDE EACH PLOT IN LOCATION AS INDICATED


STORMWATER:  
STORM / RAINWATER INSPECTION / CONNECTION CHAMBER PROVIDED ON PLOT 4 ONLY. THIS IS PLUMBED TO FIREWATER STORAGE TANK OPPOSITE, AND WILL BE CONNECTED TO PLOT 4 RAINWATER DRAINAGE TO PROVIDE A FLOW / AGITATION TO FIREWATER STORAGE TANK TO PREVENT STAGNATION OF WATER WITHIN TANK. AN OVERFLOW SOAKAWAY IS PROVIDED FOR TANK TO ALLOW EGRESS OF WATER

PLOTS:  
OUR SURVEY FOR SERVICES WAS PERFORMED USING TRIMBLE TOTAL STATION, AND IS FOR THE PURPOSE OF SERVICE LOCATION ONLY. HOUSE POSITIONS SHOWN ARE INDICATIVE ONLY. IT IS THE INDIVIDUAL PLOT OWNERS RESPONSIBILITY TO USE THEIR OWN ENGINEER TO SET OUT EXACT BOUNDARY/HOUSE POSITIONS AND THEY MUST NOT RELY ON THIS DRAWING FOR THOSE PURPOSES

MISC:  
THIS DRAWING WAS PRODUCED USING AUTOCAD® 2018 IN A1 FORMAT, AND MUST NOT BE USED TO SCALE FROM DUE TO VARIANCES IN PRINTING AND COPYING. IF IN DOUBT - ASK  
WHILST EVERY CARE HAS BEEN TAKEN TO ENSURE ACCURACY OF LOCATIONS, NO LIABILITY WILL BE BORNE BY SMPCLTD FOR ANY SUBSEQUENT SERVICE STRIKES OR DAMAGE ON SITE

A		AS BUILT - ISSUED	IST	RHA	KJA	5.6.19
Rev	Description	Drawn	Chk'd	App'd	Date	
Originated By	Drawn By	Checked By	Approved By			
IST	IST	RHA	KJA			
Date	Date	Date	Date			
31.05.2019	31.05.2019	RHA	KJA			

Reviewed (and / or Approved) For SMPCLTD By: Date:

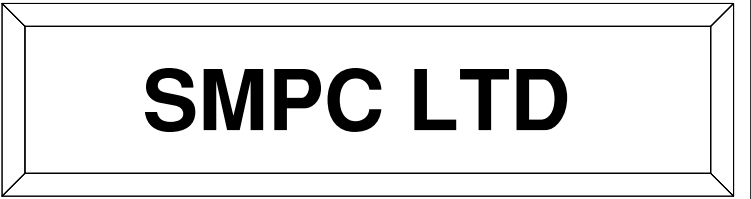

FOR: **HIGHLAND SMALL COMMUNITIES HOUSING TRUST**

SHANE MACLENNAN PLANT CONTRACTORS LTD TEL: (01463) 783296  
LOWER LEANASSIE, KILMORACK  
BEAULY, INVERNESS-SHIRE info@shanemacleanplant.co.uk

Scale 1:250, 1:1000 Status AS BUILT - ISSUED

Project Title HSCHT HOUSING - OLD SAWMILL INVERDRIE

Drawing Title SITE SERVICES AND LAYOUT AS BUILT ARRANGEMENT

SMPCLTD PROJECT NUMBER 019-068

Drawing No. AB-SMPC-019-068-010